


POWER TRANSFORMER

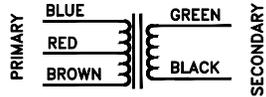

OUTPUT TRANSFORMER

6CA4 PINS:


- 1 PLATE #1
- 2 NO CONNECTION
- 3 CATHODE
- 4,5 HEATER
- 6 NO CONNECTION
- 7 PLATE #2
- 8 NO CONNECTION
- 9 NO CONNECTION

EL84 PINS:

- 1 INTERNALLY CONNECTED
- 2 CONTROL GRID (GRID 1)
- 3 CATHODE (GRID 3)
- 4,5 HEATER
- 6 INTERNALLY CONNECTED
- 7 ANODE (PLATE)
- 8 INTERNALLY CONNECTED
- 9 SCREEN (GRID 2)

12AX7 PINS:

- 1 PLATE #1
- 2 GRID #1
- 3 CATHODE
- 4,5 HEATER
- 6 PLATE #2
- 7 GRID #2
- 8 CATHODE
- 9 HTR. CENTER TAP

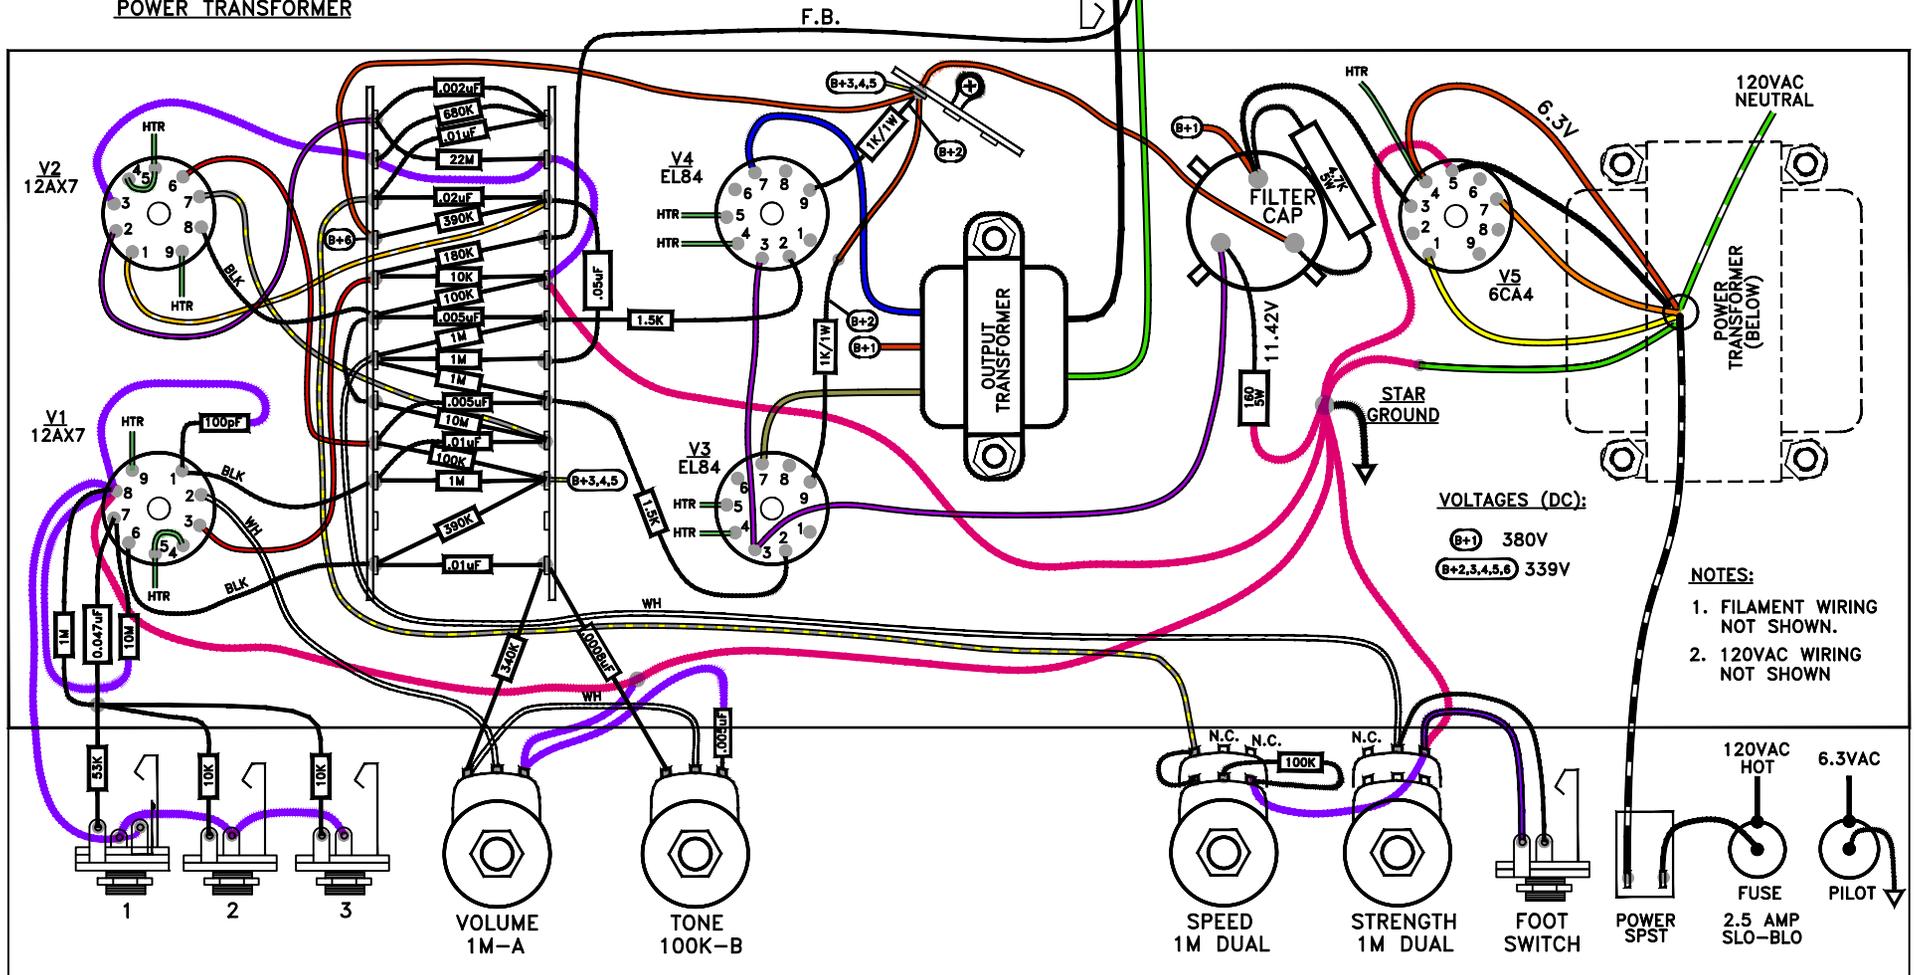

Gregory MARK X
 As-Built Chassis Layout
 Star Ground Conversion
 Paul Marossy 5/22/05

NOTES:

- 1. 1K SCREEN RESISTORS ADDED AT V3 & V4.
- 2. VOLTAGES SHOWN HERE DIFFER FROM SCHEMATIC.